


EXAMPLE ONLY

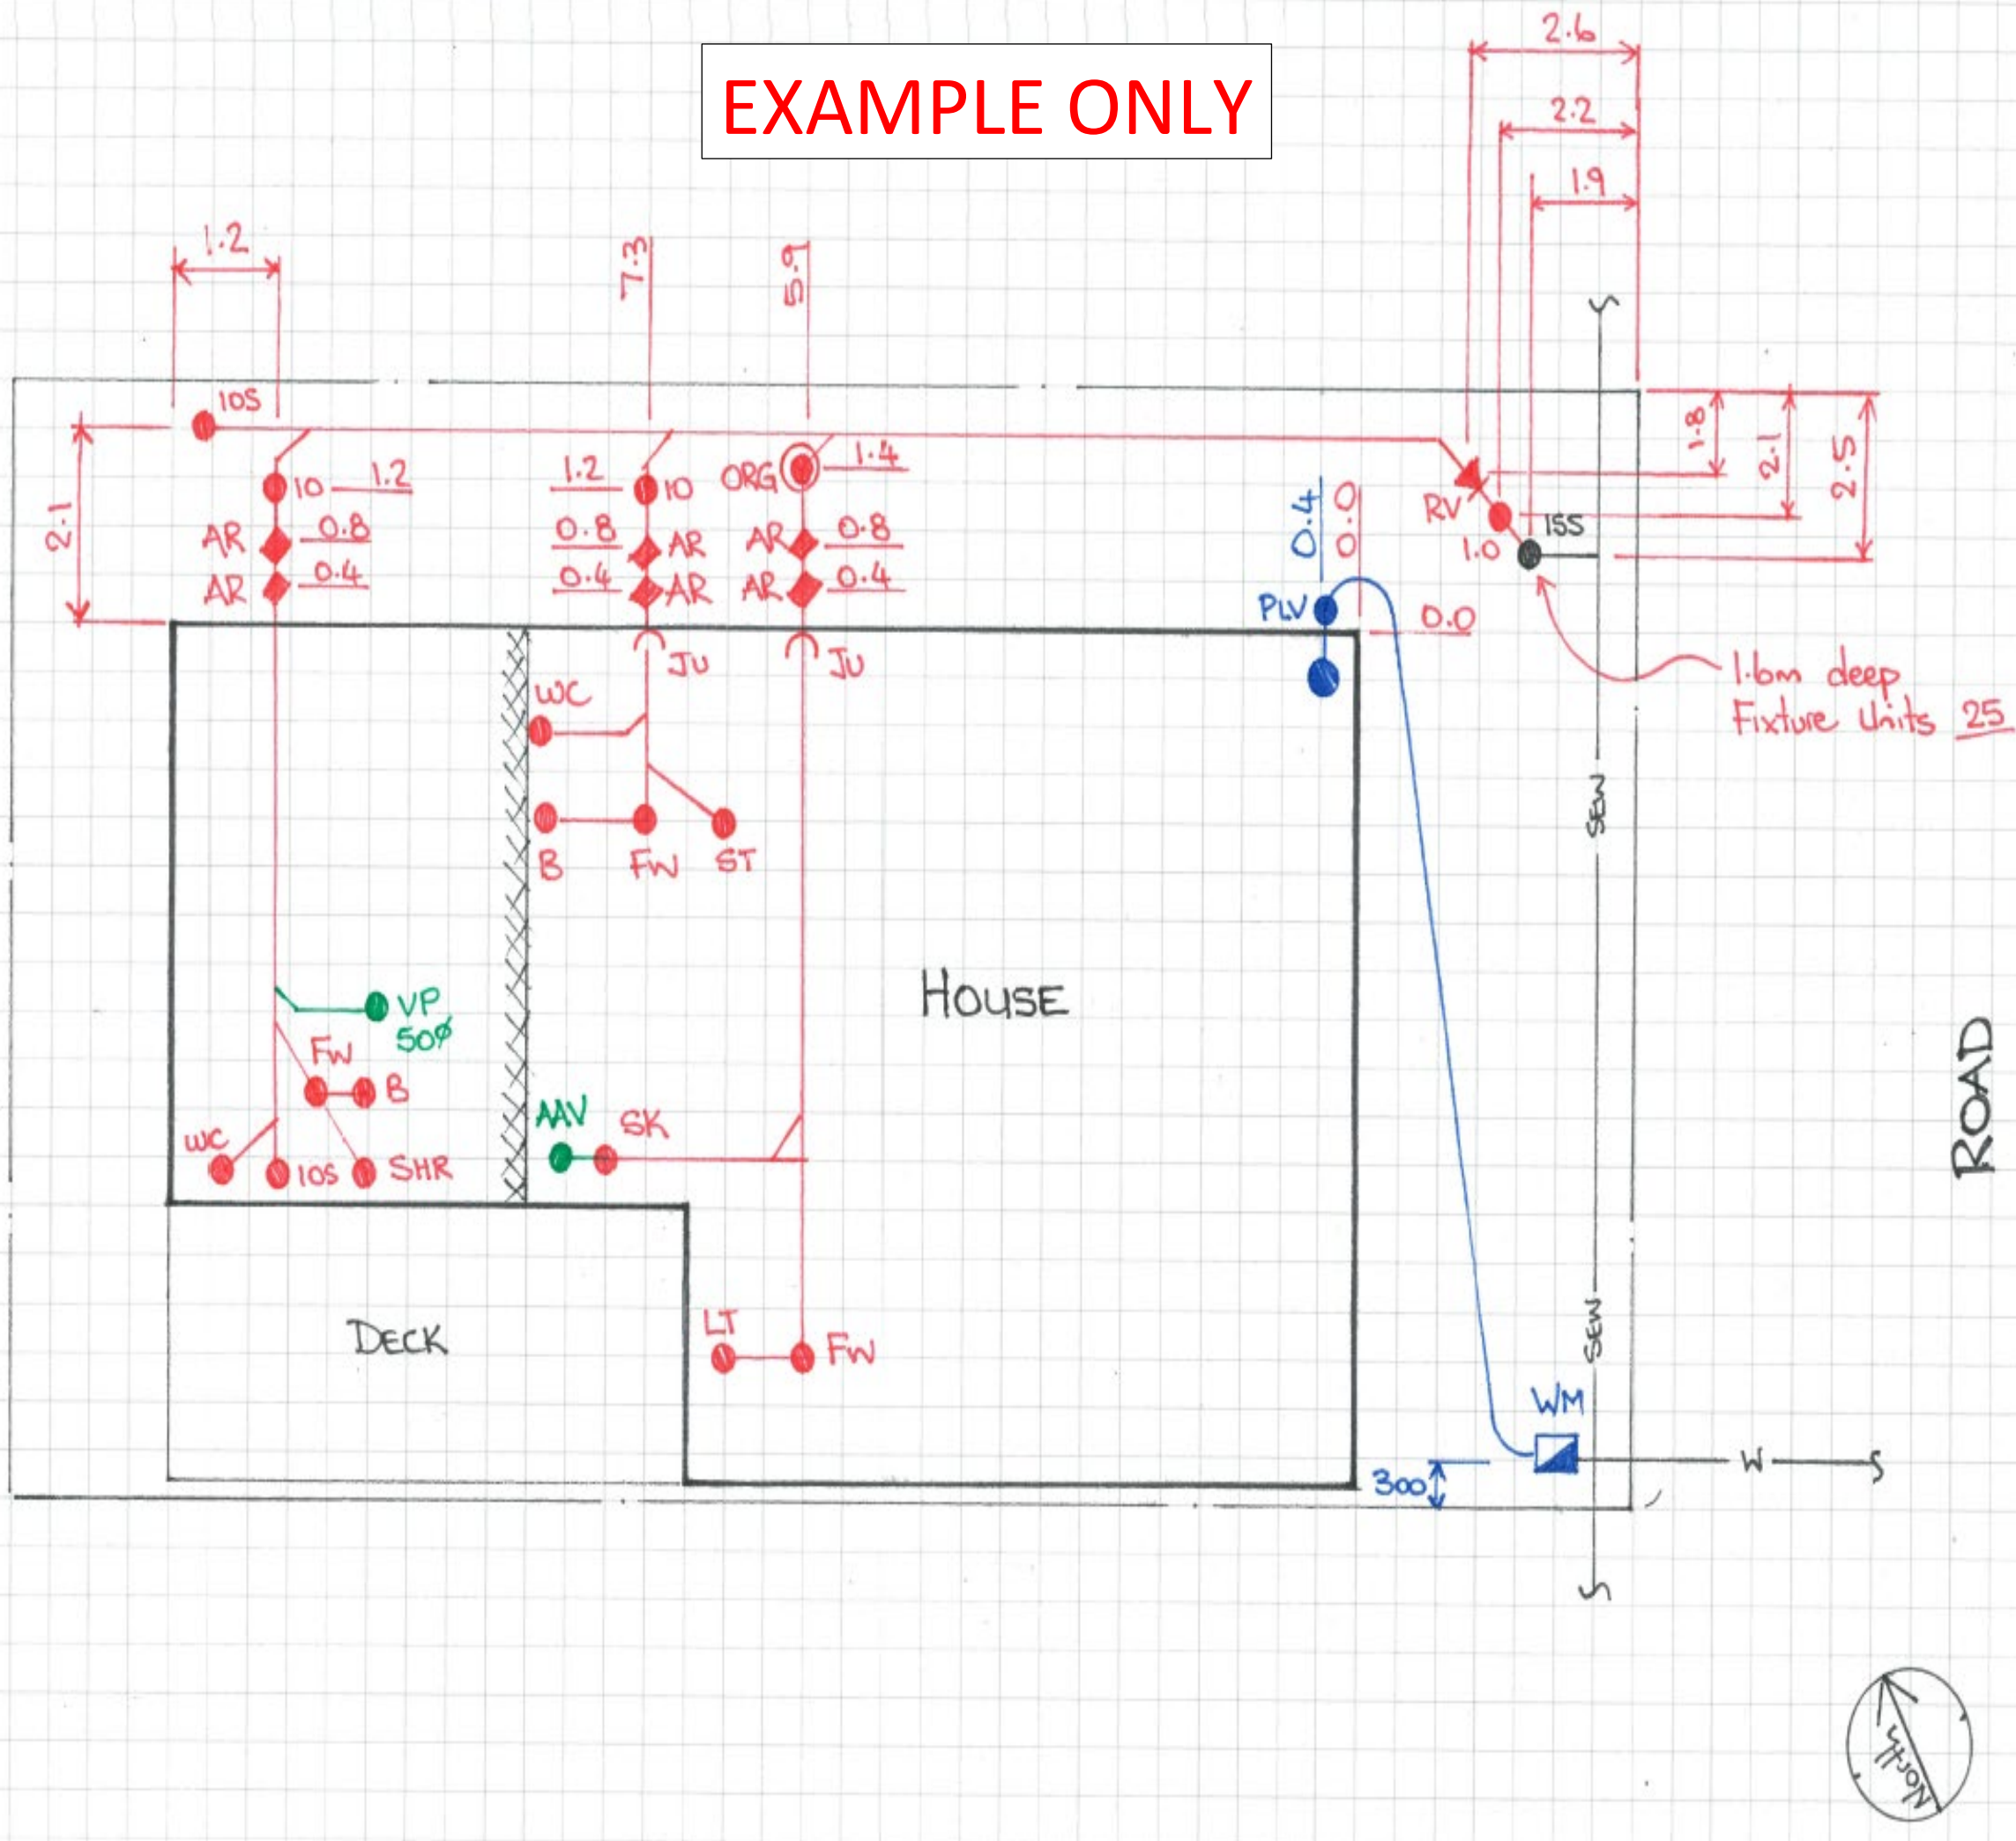

PROJECT DETAILS

Permit Number ...311.123456.....

Address...5 Miller St, Bargarra.....

Lot and Plan Details...Lot 1 on SP 123456.....

AS CONSTRUCTED

INSTALLED BY

Responsible Person...John Plumbing.....

Licence Number...123456.....

Date...05 January 2020.....

LEGEND

ABBREVIATIONS	
AAV	AIR ADMITTANCE VALVE
AR	ARTICULATION
B	BASIN
BID	BIDET
BTH	BATH
CWM	CLOTHES WASHING MACHINE
DG	DISCONNECTOR GULLY
FW	FLOOR WASTE GULLY
GIT	GREASE INTERCEPTOR TRAP
IO	INSPECTION OPENING
IOS	INSPECTION OPENING TO SURFACE
ISS	INSPECTION SHAFT TO SURFACE
JU	JUMP UP
LT	LAUNDRY TROUGH
ORG	OVERFLOW RELIEF GULLY
PCV	PRESSURE CONTROL VALVE
SAN	SANITARY DRAIN / PLUMBING
SHR	SHOWER
SK	SINK
SPA	SPA BATH
ST	STACK
TD	TUNDISH
VP	VENT PIPE
WC	WATER CLOSET
WM	WATER METER
WWTP	WASTE WATER TREATMENT PLANT

NEW SERVICE	
BORE WATER	—BW—
IRRIGATION	—IR—
HOUSE DRAIN	—HD—
VENT	—V—
WATER	—W—

GENERAL	
BOUNDARY	— — — — —
RETAINING WALL	XXXXXXXXXX

DRAWN Sign here	DATE 05/01/2020	SHEET 1/1	REV. 1
--------------------	--------------------	--------------	-----------